



2023:
 RELOCATE S1-1,
 S5-1(20)W/ S7-1T AND
 R2-1(40) W/S5-2 SIGNS
 100' NORTH OF
 CURRENT LOCATION
 TO PROVIDE MAXIMUM
 RECOMMENDED
 WARNING DISTANCE
 PER TEXAS INSTITUTE
 PUBLICATION, SPEEDS
 IN SCHOOL ZONES

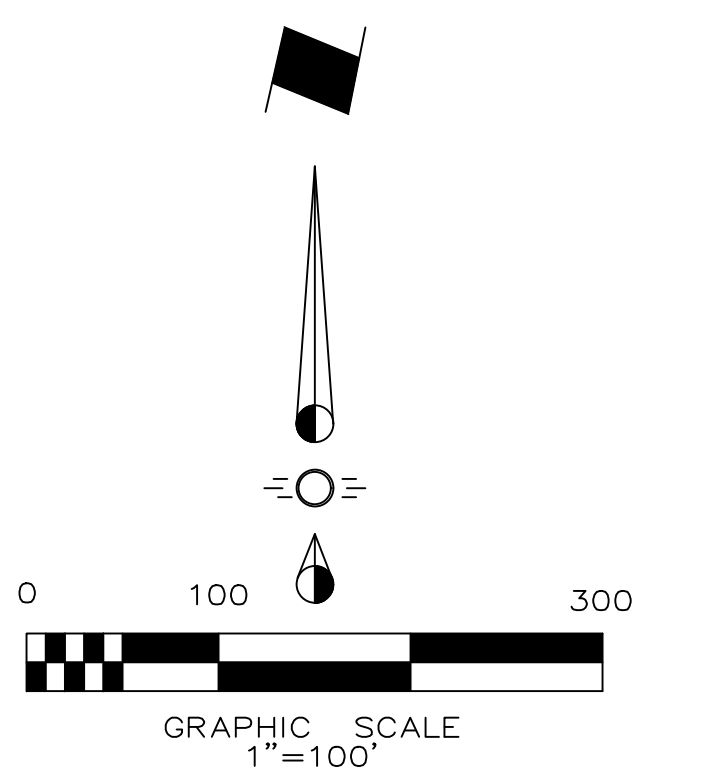

CAUTION EXISTING UTILITIES !!!
 All existing utilities and underground facilities that are indicated and shown on these plans are approximate, and are based on as-built plans and/or from reference information. Actual utility locations may differ from the as-built plans based on field observations. All utilities shall be field verified and located prior to any excavation or boring. It shall be the responsibility of the Contractor to verify both horizontally and vertically the location of such existing utilities prior to any construction.

LEGEND

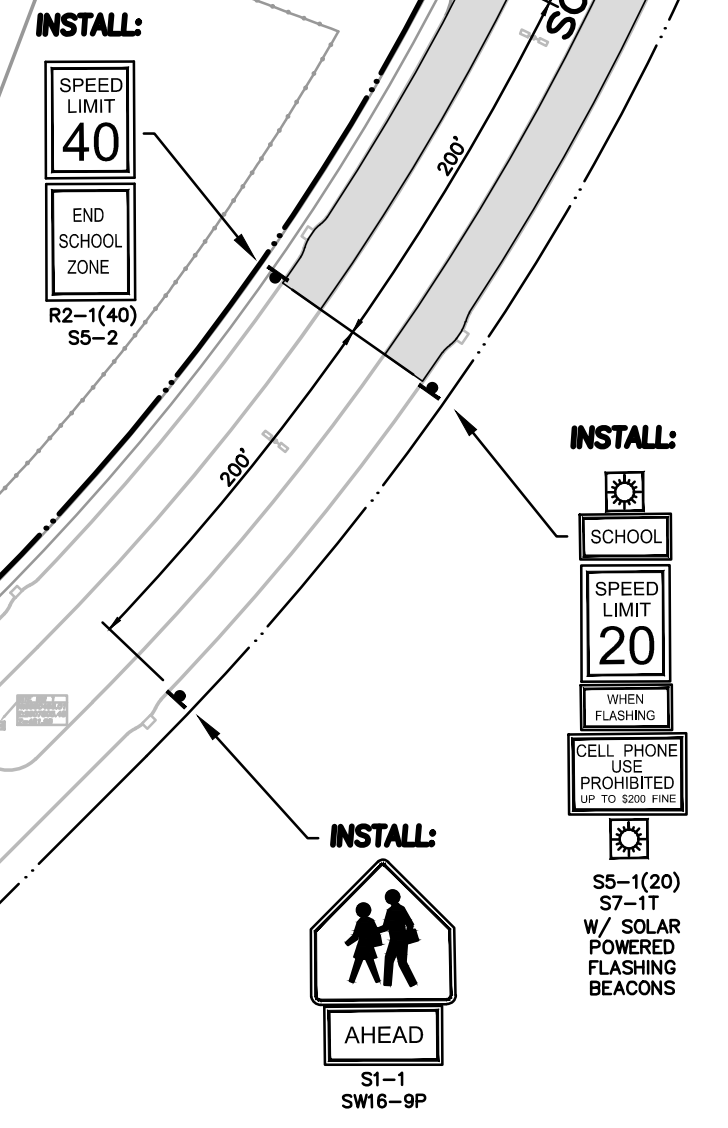

SITE BENCHMARKS:
 Site BM 1 - "x" cut in concrete in center of north median at the intersection of S. Gateway Blvd. and located S 07°21'08" E 89.3' from the southeast corner of the school site. Elev. 461.58
 Site BM 2 - "x" cut in concrete on inlet on the west side of S. Gateway Blvd. located N 12°44'50" E 86.6' from the northeast corner of the school site. Elev. 477.01

SITE BM 1: N 269°58.01 E 2.829352.06 ELEV 461.58
 SITE BM 2: N 32°16.00 E 2.477011.06 ELEV 477.01

Apr 13, 2022 - 11:49am User: Frank

NOTE:	MISC. INFORMATION		
	REVISION	DATE	DESCRIPTION
Prior to beginning any construction or construction staking, it shall be the Contractor's responsibility to contact the civil engineer to insure that all parties are in possession of the most current set of construction documents.			

RLK ENGINEERING, INC.
 111 West Main
 Allen, Texas 75013
 (972) 359-1733 Off
 (972) 359-1833 Fax
 Texas Registration No. 579

SCHOOL SIGNAGE PLAN
 DON R. WILLETT ELEMENTARY SCHOOL
 FORNEY, TEXAS

SIGNED BY: RLK Engineering	TECH REVIEW: RLK	DRAWING FILE: 19099 SIGNAGE - SCHOOL.ZONE.dwg	DRAWING SCALE: AS SHOWN	SHEET: CSP-1
DRAWN BY: RLK Engineering	PEER REVIEW: RLK	DRAWING DATE: 4-8-2022	PROJECT NUMBER: RLK.19099	